

8'-0" x 16'-0" (ACTUAL SIZE) 816 GUARDHOUSE

Twin Modular Services Inc.

1001 Lower Landing Road Suit 607, Blackwood , NJ

PROJECT:
H&K Group Inc.
2052 Lucon Road
Skippack, PA. 19474

DESIGN BASIS	
State/Jurisdiction	Pennsylvania
Building Code	International Building Code, 2009 Edition
Plumbing Code	International Plumbing Code, 2009 Edition
Electrical Code	National Electric Code NFPA 70, 2008 Edition
Mechanical Code	International Mechanical Code, 2009 Edition
Energy Code	International Energy Conservation Code, 2009 Edition
Fire Code	International Fire Code, 2009 Edition

LIFE SAFETY SUMMARY			
Construction type	VB		
Sprinkler Increase, I _S	1.00		
Frontage Increase, I _F	1.00		
Allowable Area Per Story, A _A	900 ft ²		
Allowable Height Above Grade	2 stories		
	40 ft		
LEVEL	OCCUPANCY	AREA	OCCUPANT LOAD
1	B	96 ft ²	1

STRUCTURAL DESIGN CRITERIA			
GRAVITY LOADS		Floor Live	50 psf
		Floor Dead	10 psf
		Roof Live	20 psf
		Roof Dead	10 psf
		Exterior Wall Dead	5 psf
SNOW		Ground Snow Load	40 psf
		Flat-Roof Snow, P _f	30.8 psf
WIND		Wind Speed (3 Second Gust)	90 mph
		Exposure Category	C
		Internal Pressure, GC _i	+/-0.18
		Base Wind Pressure, P _f	15.0 psf
		Mean Roof Height	15 ft
WIND		Setback	Greater than 10 feet to a common or assumed property line.
Building shall not be placed on the upper half of a hill or escarpment exceeding 15 feet in height.			
SEISMIC (IBC)		Seismic Design Category	B
		Site Class	D
		Importance Category	1.0
		Occupancy Category	II
		Mapped Accelerations	
		S _s	0.17
		S ₁	0.05
		Spectral Response	
		S _{ps}	0.18
		S _{D1}	0.08
		Seismic Force Resisting System	A13
		Design Base Shear	0.03W
		Response Modification Factor	3.0
		Analysis Procedure	ASCE 7-05 Sec. 12.8
FLOOD		Building shall not be located, in whole or in part, in a flood hazard area as established by the authority having jurisdiction unless set on a foundation designed in accordance with ASCE/SEI 25. The flood resistant foundation shall be designed by a registered design professional and constructed to resist all flood loads without transferring loads to the modular structure.	

DRAWING INDEX	
1.	Cover Sheet
1.1	General Notes
1.2	Specifications
2.	Elevations
3.	Floor Plan
3.1	Framing Details
3.2	Framing Details
4.	Electrical Plan
5.	Cross Section
6.	Blocking Plan

THIS PLAN MAY BE REVERSED OR MIRRORED.

ACCESSIBILITY EXCEPTIONS

1103.2.7 Raised areas. Raised areas used primarily for purposes of security, life safety, or fire safety including but not limited to, observation galleries, prison guard towers, fire towers or life guard stands are not required to be accessible or to be served by an accessible route.

1103.2.10 Single occupant structures. Single occupant structures accessed only by passageways below grade or elevated above ground including but not limited to, toll booths that are accessed by underground tunnels are not required to be accessible.

Note: Single occupant guard structures will be placed on an elevated entrance island to the park that does not have an accessible route.

SPECIAL LIMITATIONS

Adequate handicapped restroom facilities to handle this additional occupant load created by the addition of this building to a site shall be provided in an adjacent building on the same property. The local official having jurisdiction shall verify the existing facilities.

THERMAL ZONE

This buildings design complies with or exceeds the minimum requirements for thermal zone 5a.

ATTENTION LOCAL BUILDING OFFICIAL


All work to be completed on-site is to be in compliance with all state and local codes and is subject to review, approval, and inspection by the local authority having jurisdiction. This building is designed for installation on a permanent foundation and is not intended to be moved once installed. All on-site work shall be performed by a licensed contractor with experience in the setup of modular buildings. The following list is not all inclusive, nor does it limit the items of work or materials that may be required for complete installation.

1. Complete foundation support and anchorage system.
2. Ramps, stairs and general access to building.
3. Electrical service connection (including feeders) to the building.

COMPONENTS AND CLADDING WIND LOADS		
Component	End Zone (psf)	Interior Zone (psf)
Windows & Siding	+17.7/-23.7	+17.7/-19.2
Doors	+15.0/-18.4	+15.0/-16.5
Roof Cladding	+10.0/-44.6	+10.0/-17.7
Roof Overhangs	-41.9	-25.5

NOTICE

These drawings are applicable only to the elements and loading criteria specifically provided herein. These drawings shall not be construed in any way to specify, certify or design any aspects of the building not contained herein. Elements not contained herein are to be constructed in accordance with the prescriptive requirements of the adopted building code or designed by other registered design professionals, as applicable. Specified design criteria are based solely on information provided by the client and must be verified and approved by the local authority having jurisdiction. NTA, Inc. is not responsible for fabrication or erection. If it is suspected that these drawings have been modified, substituted or altered in any way, contact NTA, Inc. directly to obtain a file copy.

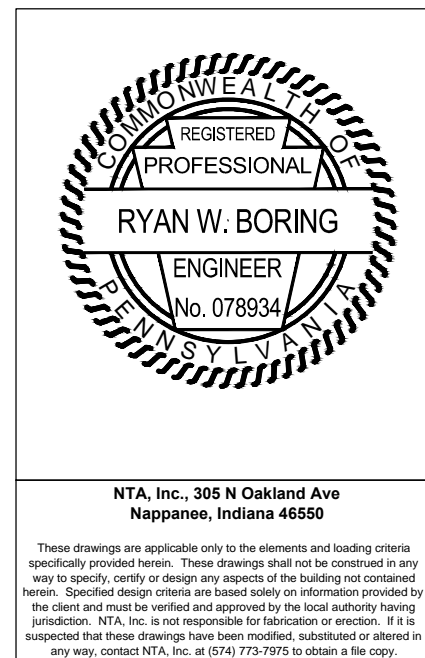

REVISIONS:	SCALE: NTS	APPROVED BY:	Twin Modular Services Inc. Blackwood , NJ	TITLE: COVER SHEET	JOB NO: TMS060617-18
	DATE: 06/07/2017	DRAWN BY: EAB		MODEL: 816 GUARDHOUSE	DRAWING NO: 1

0104 2008-05-28

WOOD FRAMING

- Structural sawn lumber shall be identified by a grade mark in accordance with DOC PS 20.
- Approved end-jointed lumber may be use interchangeably with solid-sawn member of the same species and grade except in fire rated assemblies.
- Structural sheathing shall be rated and labeled for compliance with DOC PS 1 or DOC PS 2.
- LVL members shall have the following minimum properties, E=2.0, F_v=2800 psi, unless noted otherwise.
- All wood shall have a moisture content of 19% or less at the time of construction.
- Wood framing members, including wood sheathing, that rest on exterior foundation walls and are less than 8" from exposed earth each shall be naturally durable or preservative treated.
- Wood members shall be cut and joined so no gap larger than 1/8" exists between members.
- Wood in contact with concrete or masonry shall be naturally durable or preservative treated in accordance with AWWA use category UC4C and properly identified as preservative treated.
- Nails and staples shall conform to ASTM F1667. Nails with shank diameters of 0.099" but not larger than 0.142" shall have a minimum average bending yield strength, F_y = 100 ksi.
- Fasteners shall be installed to avoid splitting of the wood members. If splitting occurs, the connection shall be made by alternate means or otherwise reinforced under the direction of the design engineer.
- Fasteners shall be driven so their head or crown is flush with the surface of the wood member or sheathing. Overdriven fasteners shall be replaced.
- Bolts shall conform to ASTM A307 meeting the requirements of ANSI/ASME B18.2.1 for full-body diameter bolts. Screws and lag screws shall conform to ANSI B18.2.1 and ANSI B18.6.1, respectively.
- Bolt holes shall be at least a minimum of 1/32" and no more than a maximum of 1/16" larger than the bolt diameter.
- Bolt nuts shall be finger-tight plus 1/3 to 1/2 turn with a hand wrench.
- Connection hardware shall be the brand and model specified. Alternate connectors shall be submitted to the design engineer for approval.
- Unless otherwise noted, connectors shall be installed with the maximum number and size of fasteners as required in the manufacturer's installation instructions.
- Prefabricated wood I-joist and structural composite lumber shall not be notched or drilled except where permitted by the manufacturer's recommendations.
- Plywood beams shall be detailed and fabricated in accordance with the latest edition of APA Plywood Design Specification Supplement 5 - Design & Fabrication of All-Plywood Beams.
- Douglas Fir, Hem Fir, or Southern Yellow Pine may be substituted for Spruce-Pine-Fir using an equal size and grade.

CORROSION PROTECTION

- Metal framing, connectors, fasteners, and flashing in contact with preservative treated or fire retardant treated wood members shall be hot-dipped zinc coated galvanized steel, stainless steel, silicon bronze, copper, or otherwise protected from the corrosive action of the wood member.
- A barrier between the treated members can be used when approved by the design engineer.
- Selection of the appropriate connector and fastener coating shall be based on the intended end use of the connector or fastener and the chemical preservative used in the treatment of the member for which it is in contact.
- Where connection hardware is used, such as joint hangers, fasteners used shall be made of the same material as the connection hardware.
- Corrosion protection of metal connectors, fasteners, and flashing based on galvanized or stainless steel materials shall be in accordance with the table below.

Product Coatings	Hot Dipped Galvanized (ASTM A153)		Stainless Steel
	G90	G185	
Untreated Wood SBX/DOT CCA-C	Yes	Yes	Yes
ACQ-C & ACQ-B CBA-A & CA-B NON-DOT No Ammonia and Not Rated For Ground Contact	No	Yes	Yes
Unknown Preservative, Contains Ammonia, Rated For Ground Contact or ACZA	No	No	Yes

SBX = DOT Sodium Borate, CCA-C = Chromated Copper Arsenate, ACQ-C & ACQ-D = Alkaline Copper Quat, CBA-A & CA-B = Copper Azote, Non-DOT = Other Borate, ACZA = Ammoniacal Copper Zinc Arsenate

COASTAL CORROSION PROTECTION

- The corrosion protection requirements in this sections shall apply to all structures located within 3000' landward of the mean high-tide waterline for all metal components or connectors not contained within the pressure envelope of the structure.
- Fasteners or bolts less than 5/8" in diameter shall be Type 316L stainless steel. Fasteners or bolts 5/8" or larger shall be hot dip galvanized per ASTM A653 or ASTM A153 with a zinc coating thickness of 1.85 oz of zinc per square foot of surface area (G185).
- Connection hardware, such as pre-formed connectors, steel plates, or steel straps, exposed to weather and having a base metal thickness equal to or less than 1/8" shall be Type 303, 304, 305 or 316 stainless steel. Steel exposed to weather having a base metal thickness greater than 1/8" shall be hot dip galvanized per ASTM A653 or ASTM A153 with a zinc coating thickness of 1.85 oz of zinc per square foot of surface area (G185) or painted using one of the following formulations:
 - Epoxy-polyamide
 - Coal-tar epoxy-polyamide
 - Zinc chormate-vinyl butyral primer with asphaltic mastic
- Contact between dissimilar materials (stainless steel and carbon steel) shall be avoided.



NTA, Inc., 305 N Oakland Ave
Nappanee, Indiana 46550

These drawings are applicable only to the elements and loading criteria specifically provided herein. These drawings shall not be construed in any way to specify, certify or design any aspects of the building not contained herein. Specified design criteria are based solely on information provided by the client and must be verified and approved by the local authority having jurisdiction. NTA, Inc. is not responsible for fabrication or erection. If it is suspected that these drawings have been modified, substituted or altered in any way, contact NTA, Inc. at (574) 773-7975 to obtain a file copy.

06.04 2007-06-19

REVISIONS:	SCALE: NTS	APPROVED BY:
	DATE: 06/07/2017	DRAWN BY: EAB

Twin Modular Services Inc.
Blackwood, NJ

TITLE: GENERAL NOTES	JOB NO: TMS060617-18
MODEL: 816 GUARDHOUSE	DRAWING NO: 1.1

CHASSIS

Type: Perimeter Main Beam: 6" C Channel 8.2 lbs per foot
Cross Members: 6" C Channel at 24" o.c.
Paint: Marine Based 2 Part Epoxy-Black

FLOOR

Moisture Barrier: Tyvek or Equal
Insulation: 2 Layers of 2" Ridged Insulation R-19
Decking: 3/4" Plywood, 24" o.c. Secured Directly to Steel Frame
Trim: 4" Vinyl Cove Base - Black
Covering: 1/8" Aluminum Tread Plate Over 3/4" Plywood

EXTERIOR WALLS

Studs: 2x4 Stud Grade SPF at 16" o.c.
Bottom Plate: Single 2x4 #3 SPF
Top Plate: Single 2x4 #3 SPF
Steel Tube: 3"x3"x1/4" Steel Tube Beams and Corner Posts with
2"x2" Rigid Foam Board Insulation
Exterior Sheathing: 7/16" OSB Sheathing 24/16
Wall Height: 8'-3"
Finished Ceiling Height: 7'-9" AFF
Insulation: R-13 Kraft-Backed Batts
Interior Wall Covering: 1/4" Vinyl Covered Paneling Glued
and Stapled, Class C Finish

ROOF

Type: Rafter, 2x8 #3 SPF at 16" o.c. Bow Type
Ceiling: 2'x4' T-Grid Drop Ceiling at 7'-9" AFF
Insulation: R-30 Kraft Unfaced Fiberglass Batts
Overhang: 3" On Each 16' Side and 6" On Each 8' Side
Exterior Sheathing: 1/2" Exterior Grade Plywood 24/16

ENERGY PACKAGE

Exterior Light: (1) 120V LED 39 Watt Model FSL2030L with Photocell (Weather Proof) or Equal
Interior Lights: (2) 2'x4' 120V LED with Prismatic Lens - Lithonia Type U889966

ELECTRICAL

Main Distribution Panel: **Exterior Surface** Mount Below Window with 1-1/2" Conduit to Exterior, 100 Amp. Three
Phase, 4 wire, 60 HZ
Ground Raceway: Minimum #14/2 with Ground 90 Deg. C Type MC Copper
Interior Lights: See Above Energy Package
Exterior Lights: See Above Energy Package
Switches: 120V 15 Amp Duplex Recept per Print
Recepts: 20 Amp - 120V Duplex Recept per Print
Interior Recept: 20 Amp - 120V GFCI - per Print
Data Box: 4" Data Box Surface Mounted and Piped to Ceiling - Wiring by Others

HVAC

Heating: (2) 230V, 20 Amp, 3,000 Watt Wall Mount, Dedicated Circuit
Air Conditioning: 208/230V (Dedicated Circuit) 12,000 BTU Wall Mount Approx 75" AFF
Optional: Wall Mount 11,600 BTU Air Conditioner with Electric Heat Strip

EXTERIOR WINDOWS AND DOORS

Doors: 36"x80" Steel Door with 22" x36" Window (Safety Glazed) Ball Hardware and Heavy Duty Closer
Windows: 46"x39" Horizontal Slider, Vinyl Clad Thermal Pane Tempered Low-E Type **1** per Print
46"x39" Fixed Glazing, Vinyl Clad Thermal Pane Low-E Type **3** per Print
36"x39" Fixed Glazing, Vinyl Clad Thermal Pane Low-E Type **1** per Print

Optional: Film Tint Windows

Note: All Windows including Door Window to be Tempered
#4 Window -(1) 36" x 39" Vinyl Thermal Insulated Tempered Low Sliding

#5 Window -(1) 30"x39" Vinyl Thermal Insulated Tempered Low-E Fixed

EXTERIOR FINISHES

Siding: 0.19 Aluminum Light Gray
Trim: 0.19 Aluminum Dark Gray
Wall Sheathing: 7/16" OSB, 24/16 APA Span Index Rating Minimum
Roof Sheathing: 1/2" CDX Plywood, 32/16 Span Rating Minimum
Roof: GAF TPO - White - Class C, 1/2" ISO Guard HD or Resista
Window Trim: 2-1/2" Non Corrosive Solid Vinyl Painted White

FURNITURE

None

PLUMBING NON ADA

Water Closet: White Standard Gravity Flush
Urinal: None
Lav: Wall Hung With Faucet
Water Heater: 120 Volt 20 Amp Direct Point
Supply: 3/4" Copper Water Feed- 1/2" Copper
Water Feed
Waste: 3" schedule 40 Main Connection
Misc: Wall Hung Mirror
Accessories: Toilet Paper Holder
Fan: Exhaust In Bath
Soap Dispenser: Tough Guy #3FPN8-Push Oper
Paper Towel Dispenser: Georgia Pacific #54338



NTA, Inc., 305 N Oakland Ave
Nappanee, Indiana 46550

These drawings are applicable only to the elements and loading criteria specifically provided herein. These drawings shall not be construed in any way to specify, certify or design any aspects of the building not contained herein. Specified design criteria are based solely on information provided by the client and must be verified and approved by the local authority having jurisdiction. NTA, Inc. is not responsible for fabrication or erection. If it is suspected that these drawings have been modified, substituted or altered in any way, contact NTA, Inc. at (574) 773-7975 to obtain a file copy.


06.04 2007-06-19

REVISIONS:	SCALE: NTS	APPROVED BY:
	DATE: 06/07/2017	DRAWN BY: EAB


Twin Modular Services Inc.
Blackwood, NJ

TITLE: SPECIFICATIONS	JOB NO: TMS060617-18
MODEL: 816 GUARDHOUSE	DRAWING NO: 1.2


PLAN A ELEVATIONS

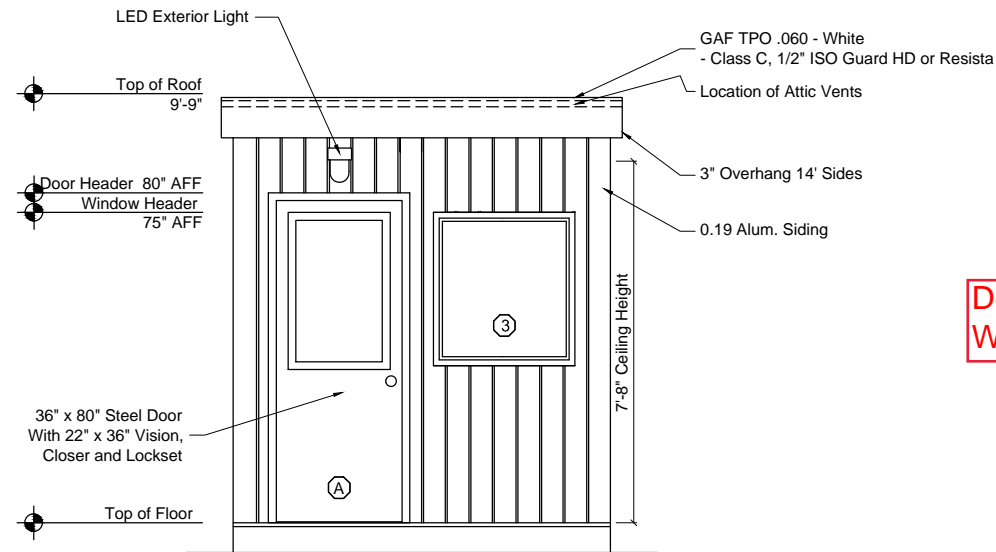


FRONT ELEVATION- PLAN A
SCALE: 1/4" = 1'-0"

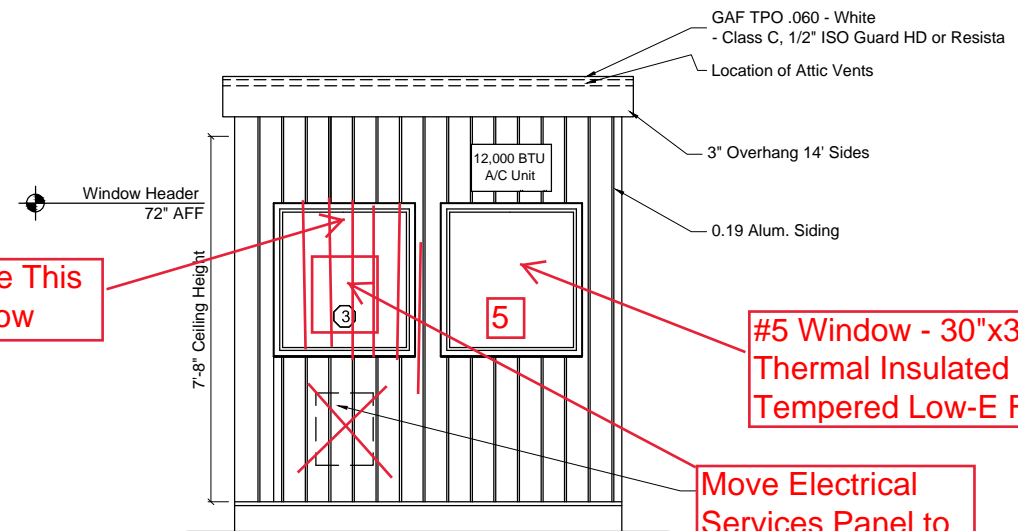


REAR ELEVATION- PLAN A
SCALE: 1/4" = 1'-0"

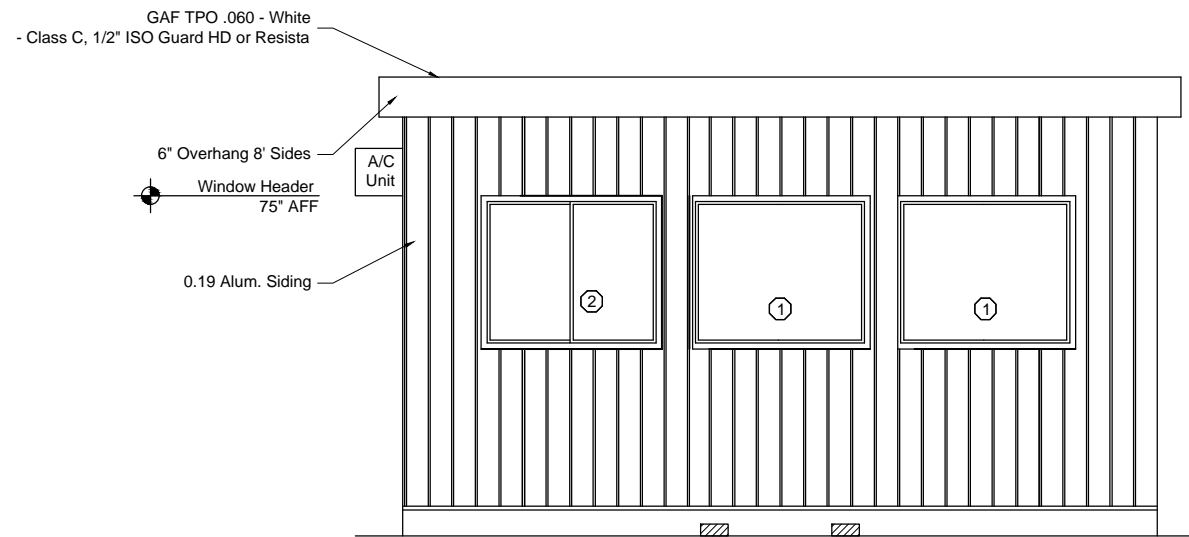

LEFT ELEVATION- PLAN A
SCALE: 1/4" = 1'-0"

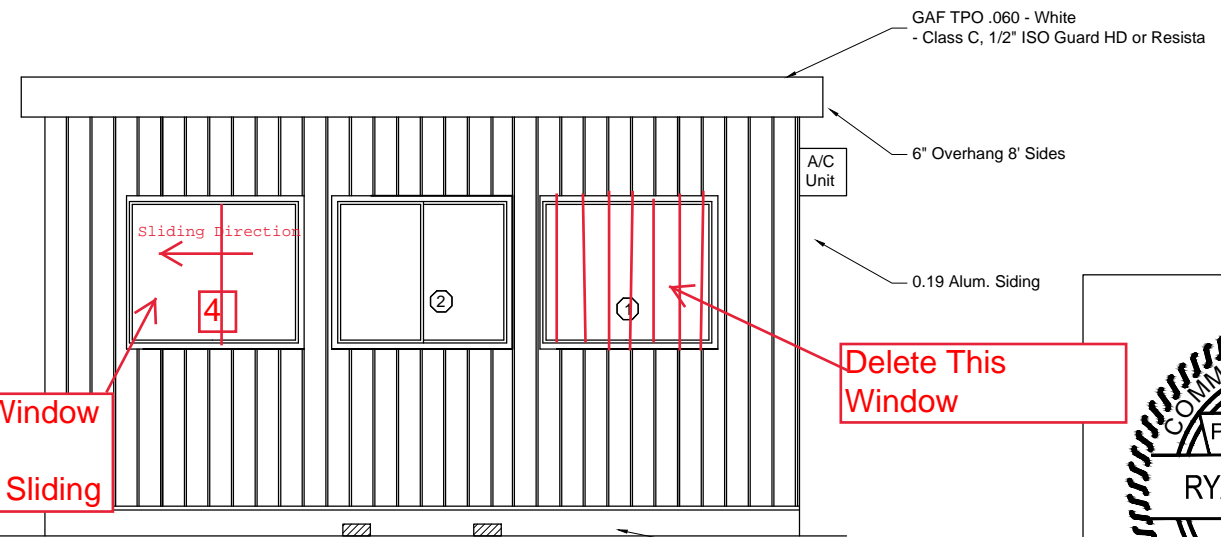

RIGHT ELEVATION- PLAN A
SCALE: 1/4" = 1'-0"

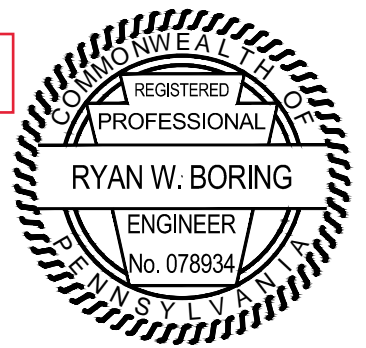

NTA, Inc., 305 N Oakland Ave
Nappanee, Indiana 46550

These drawings are applicable only to the elements and loading criteria specifically provided herein. These drawings shall not be construed in any way to specify, certify or design any aspects of the building not contained herein. Specified design criteria are based solely on information provided by the client and must be verified and approved by the local authority having jurisdiction. NTA, Inc. is not responsible for fabrication or erection. If it is suspected that these drawings have been modified, substituted or altered in any way, contact NTA, Inc. at (574) 773-7975 to obtain a file copy.

DOOR SCHEDULE	
Mark	Description
(A)	36" x 80" Steel Door with 22" x 36" Window, Closer and Ball Knob
WINDOW SCHEDULE	
Mark	Description
(1)	46" x 39" Vinyl Thermal Insulated Fixed, Tempered Window, Low-E
(2)	46" x 39" Vinyl Thermal Insulated Horizontal Sliding, Tempered And Tinted, Low-E
(3)	36" x 39" Vinyl Thermal Insulated Fixed, Tempered, Low-E

ATTIC VENTILATION
Vents shall be installed to provide a total net free ventilating area not less than 1/150 of the area of the space being ventilated.
Vents shall be positioned to provide cross ventilation.

96 Area /150= 0.64 sq. ft. Ventilation Required

SITE INSTALLED ITEMS
Steps, rails, and decks are to be designed by others and built on-site in accordance with local codes and subject to approval by the local authority having jurisdiction.

HEIGHT ABOVE FINISHED GRADE
Wood framing members, including wood sheathing, that are less than 8" from exposed earth shall be of naturally durable or preservative-treated wood.


REVISIONS:	SCALE: 1/2" = 1'-0"	APPROVED BY:
	DATE: 06/07/2017	DRAWN BY: EAB

Twin Modular Services Inc.
Blackwood, NJ

TITLE: ELEVATIONS PLAN A	JOB NO: TMS060617-18
MODEL: 816 GUARDHOUSE	DRAWING NO: 2A

1015.1151 2008-12-02

3" Overhang 8' Sides,
6" Overhang 14' Sides
(See Elevation)

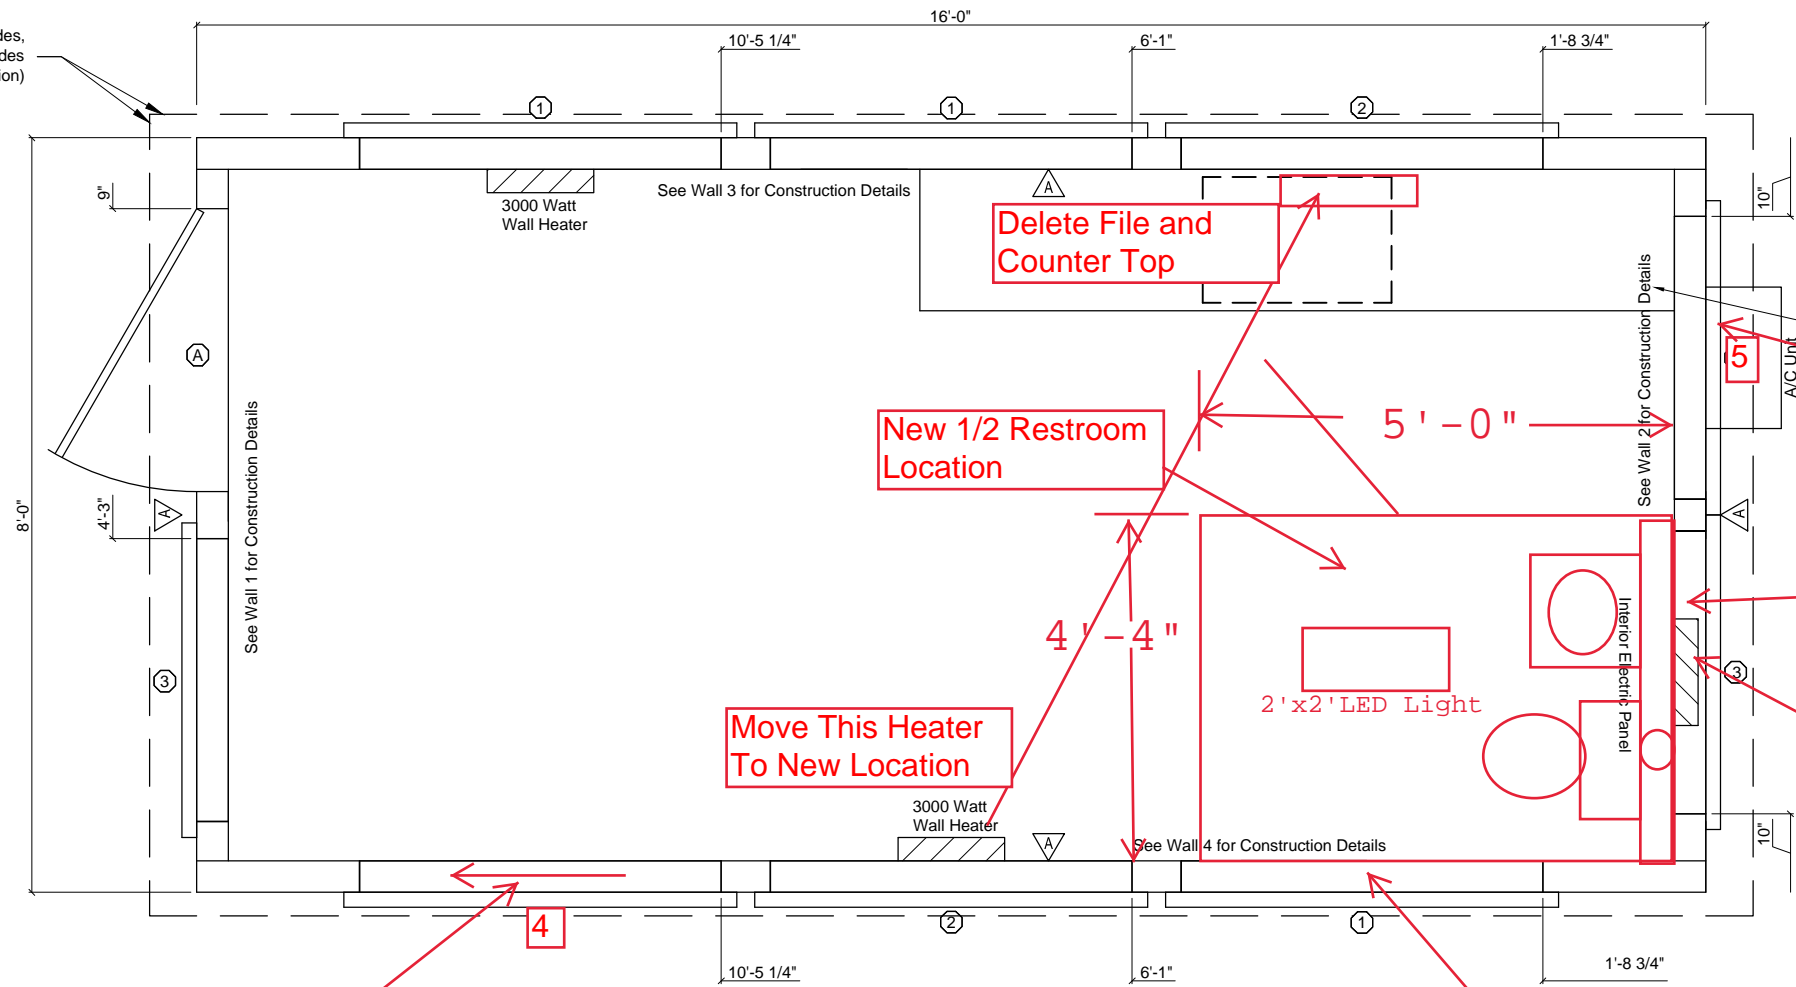

PLAN A FLOOR PLAN



NTA, Inc., 305 N Oakland Ave
Nappanee, Indiana 46550

These drawings are applicable only to the elements and loading criteria specifically provided herein. These drawings shall not be construed in any way to specify, certify or design any aspects of the building not contained herein. Specified design criteria are based solely on information provided by the client and must be verified and approved by the local authority having jurisdiction. NTA, Inc. is not responsible for fabrication or erection. If it is suspected that these drawings have been modified, substituted or altered in any way, contact NTA, Inc. at (574) 773-7975 to obtain a file copy.

GENERAL

- All glazing within 24" arc of doors, whose bottom edge is less than 60" above the floor, and all glazing in door shall be safety glazed, tempered or acrylic plastic sheet.
- Minimum corridor width shall not be less than 36".
- Exterior windows and sliding doors shall be labeled as conforming to AAMA/WDMA/CSA101/1.S.2/A440.
- Windows in buildings located in windborne debris regions shall be protected in accordance with Section 301.2.1.2 of the residential code.

SHEARWALL CONSTRUCTION

- Alternate holdown of equal or greater capacity may be substituted for holdowns specified.
- Holdowns to be installed in accordance with manufacturer's installation instructions.

BUYER ACCEPTANCE PLAN A SIGN AND DATE

DOOR SCHEDULE

Mark	Description	Hardware	Header	Jack Studs	Jamb Studs
(A)	36" x 80" Steel Door with 22" x 36" Window, Closer and Ball Knob	Ball Knob	(1) 2x4 #2 SPF	1	1

WINDOW SCHEDULE

Mark	Description	Glazed Area	Vent Area	Header	Jack Studs	Jamb Studs
(1)	46" x 39" Vinyl Thermal Insulated Fixed, Tempered Window, Low-E	12.46 ft ²	0 ft ²	(1) 2x4 #2 SPF	1	1
(2)	46" x 39" Vinyl Thermal Insulated Horizontal Sliding, Tempered And Tinted, Low-E	12.46 ft ²	6.23 ft ²	(1) 2x4 #2 SPF	1	1
(3)	36" x 39" Vinyl Thermal Insulated Fixed, Tempered, Low-E	9.75 ft ²	0 ft ²	(1) 2x4 #2 SPF	1	1

SHEARWALL SCHEDULE

Mark	Sheathing	Fastening	Framing
(A)	7/16" Structural Sheathing, One Side, Blocked	0.113" x 2.5" nails 6/12 (edge/field)	2x4 SPF @ 16" oc

See Above For #4 & #5 Windows

1/2" = 1'-0"

APPROVED BY:

DATE: 06/07/2017

DRAWN BY: EAB

Twin Modular Services Inc.
Blackwood, NJ

TITLE:

FLOOR PLAN A

MODEL:

816 GUARDHOUSE


JOB NO:

TMS060617-18

DRAWING NO:

3A

0106 2008-09-23

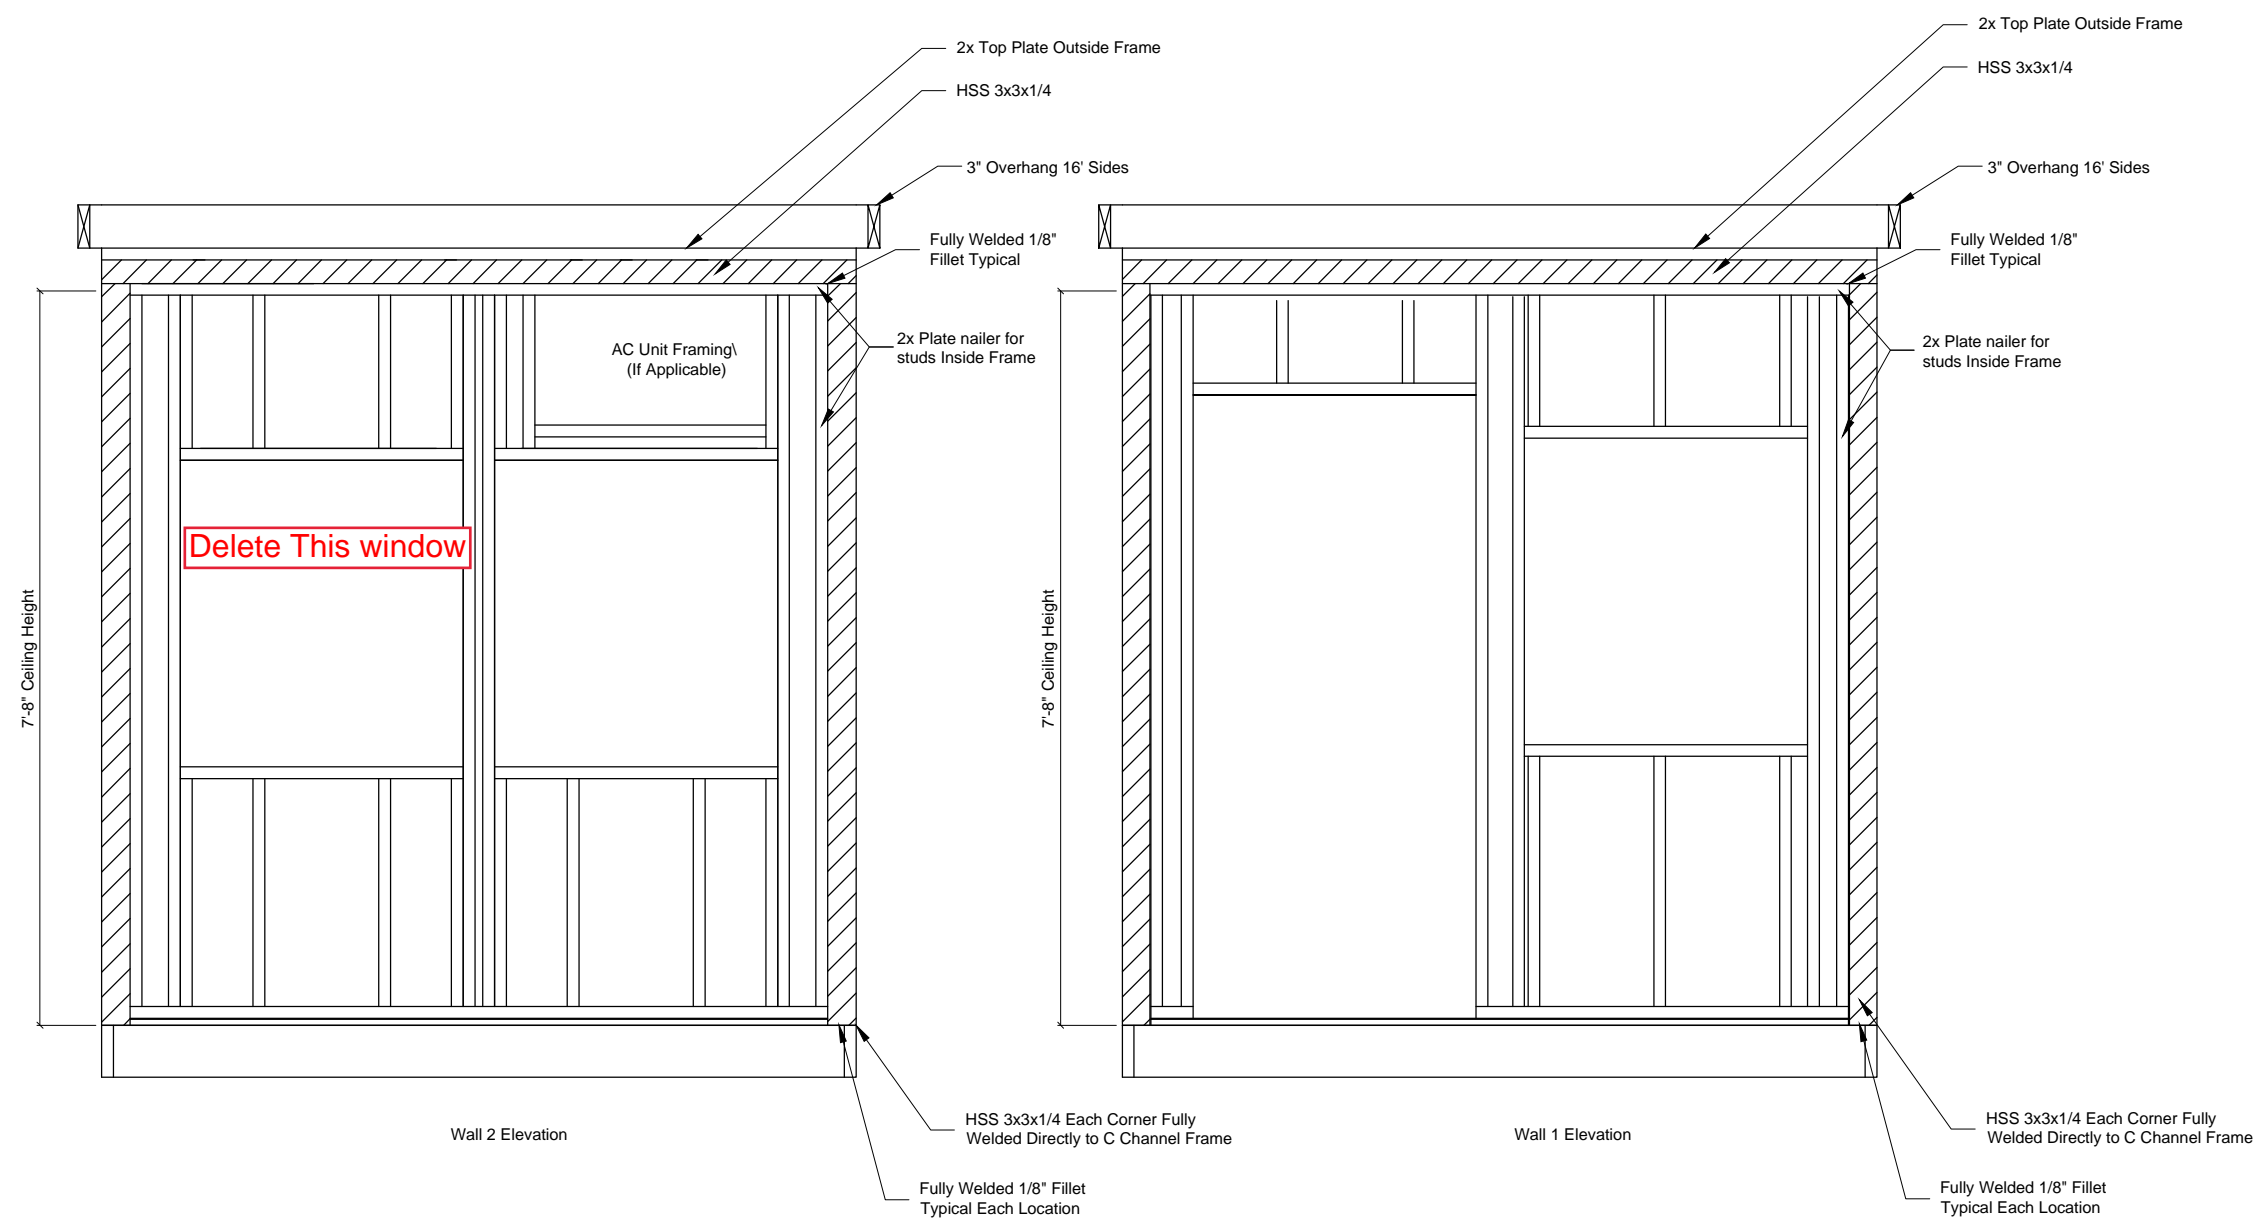

NTA, Inc., 305 N Oakland Ave
Nappanee, Indiana 46550

These drawings are applicable only to the elements and loading criteria specifically provided herein. These drawings shall not be construed in any way to specify, certify or design any aspects of the building not contained herein. Specified design criteria are based solely on information provided by the client and must be verified and approved by the local authority having jurisdiction. NTA, Inc. is not responsible for fabrication or erection. If it is suspected that these drawings have been modified, substituted or altered in any way, contact NTA, Inc. at (574) 773-7975 to obtain a file copy.


PLAN A WALL DETAILS

REVISIONS:	SCALE: 1/2" = 1'-0"	APPROVED BY:
	DATE: 06/07/2017	DRAWN BY: EAB

Twin Modular Services Inc.
Blackwood, NJ

TITLE: FRAMING DETAILS	JOB NO: TMS060617-18
MODEL: 816 GUARDHOUSE	DRAWING NO: 3.1

0106 2008-09-23

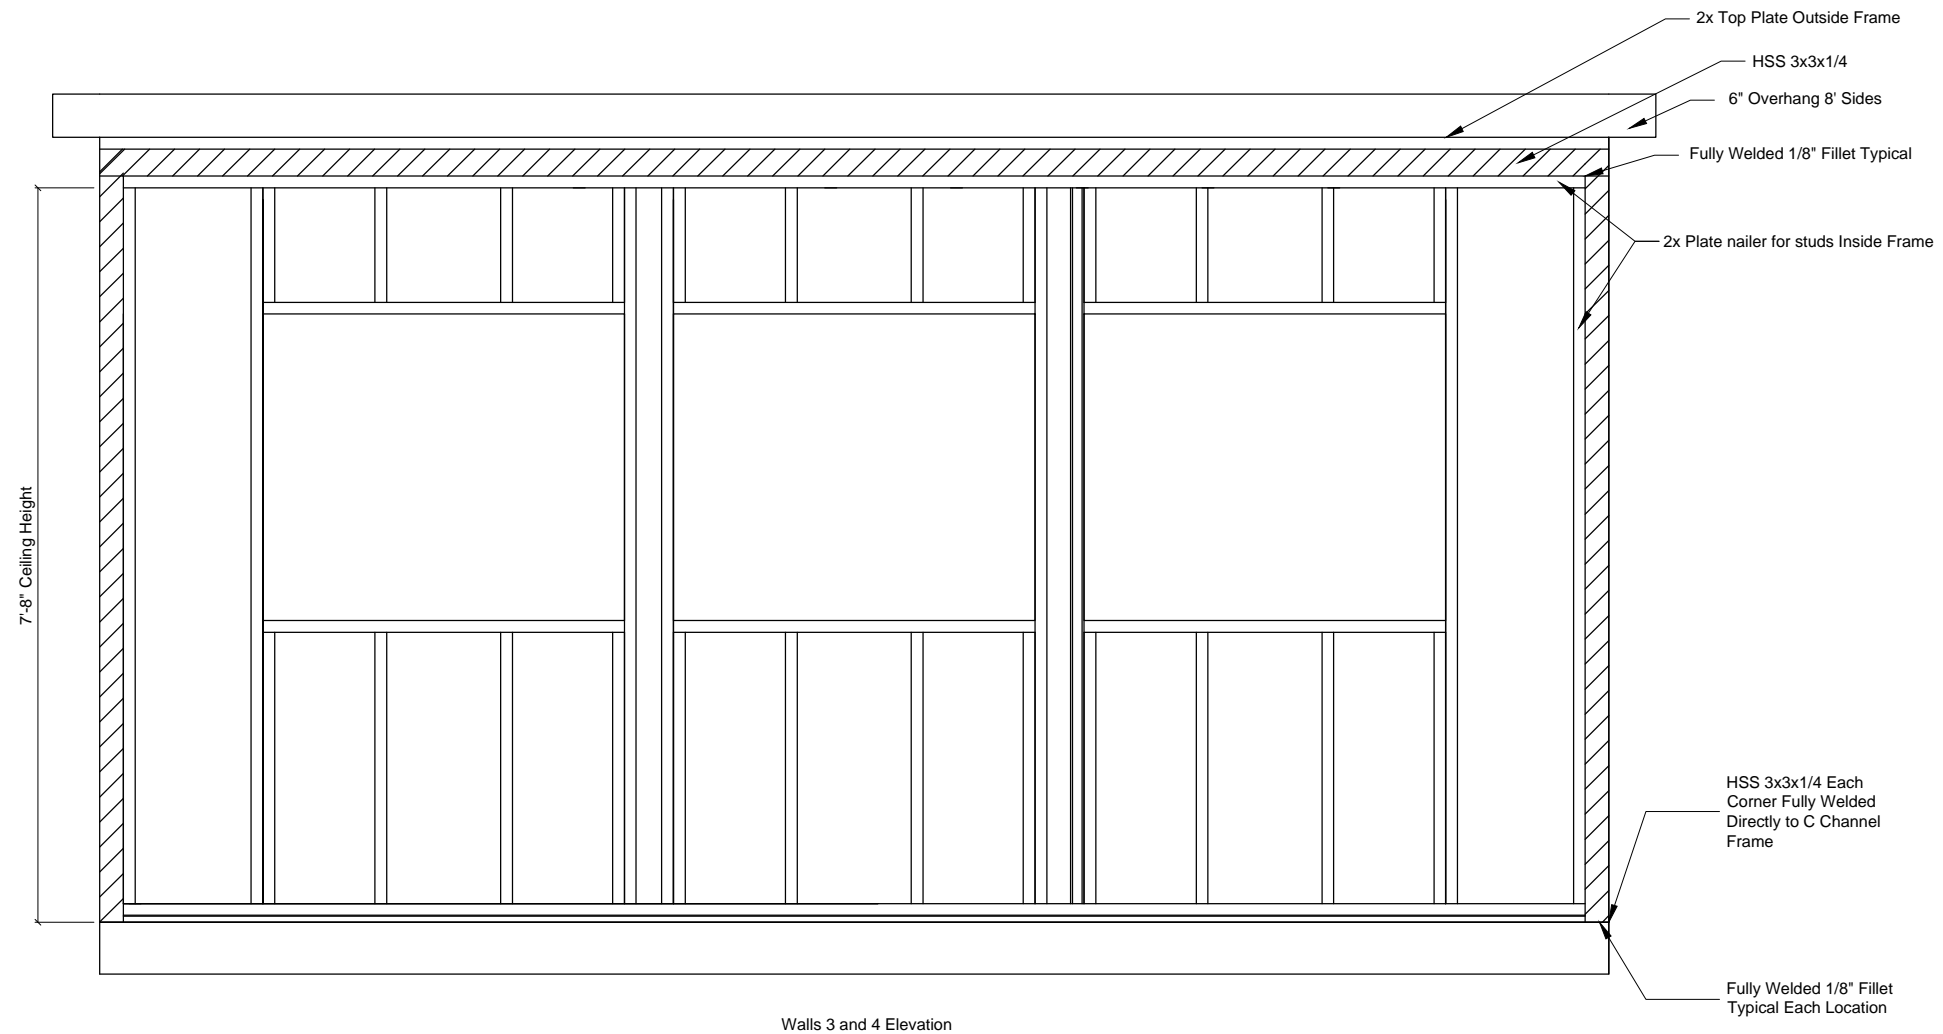

Walls 3 and 4 Elevation



NTA, Inc., 305 N Oakland Ave
Nappanee, Indiana 46550

These drawings are applicable only to the elements and loading criteria specifically provided herein. These drawings shall not be construed in any way to specify, certify or design any aspects of the building not contained herein. Specified design criteria are based solely on information provided by the client and must be verified and approved by the local authority having jurisdiction. NTA, Inc. is not responsible for fabrication or erection. If it is suspected that these drawings have been modified, substituted or altered in any way, contact NTA, Inc. at (574) 773-7975 to obtain a file copy.



PLAN A WALL DETAILS

0106 2008-09-23

REVISIONS:	SCALE: 1/2" = 1'-0"	APPROVED BY:
	DATE: 06/07/2017	DRAWN BY: EAB

Twin Modular Services Inc.
Blackwood , NJ

TITLE: FRAMING DETAILS	JOB NO: TMS060617-18
MODEL: 816 GUARDHOUSE	DRAWING NO: 3.2

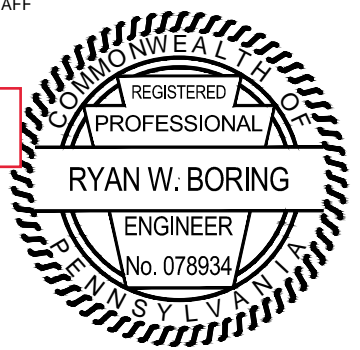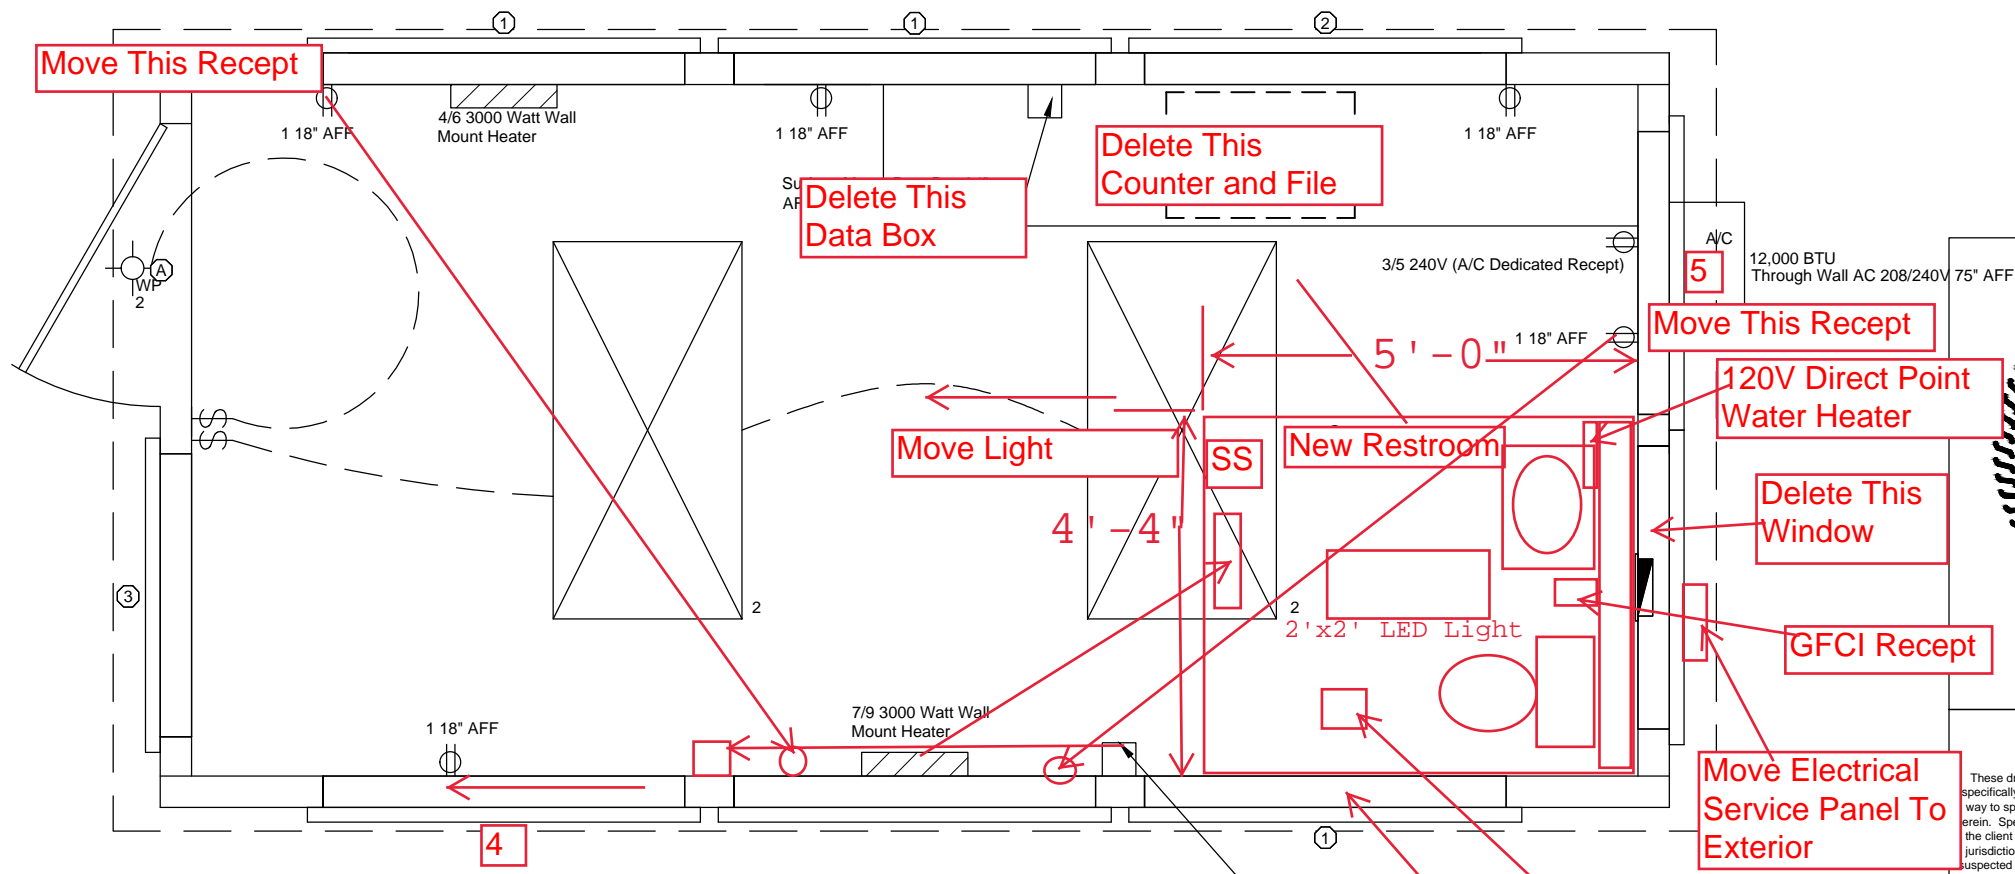

NTA, Inc., 305 N Oakland Ave
Nappanee, Indiana 46550

These drawings are applicable only to the elements and loading criteria specifically provided herein. These drawings shall not be construed in any way to specify, certify or design any aspects of the building not contained herein. Specified design criteria are based solely on information provided by the client and must be verified and approved by the local authority having jurisdiction. NTA, Inc. is not responsible for fabrication or erection. If it is suspected that these drawings have been modified, substituted or altered in any way, contact NTA, Inc. at (574) 773-7975 to obtain a file copy.

PLAN A ELECTRICAL DESIGN

BUYER ACCEPTANCE PLAN A SIGN AND DATE

Electrical Specifications

Product	Manufacturer	Model and Specifications
4,000 Watt Wall Mount Heater	Marley Fahrenheat	Model FZL3004 Fahrenheat or Equal 240V
Interior Drop in Light	Lithonia	2'x4' 120V LED with Prismatic Lens - Lithonia
Exterior Lighting	Lithonia	120V LED 39 Wall Model FSL2030L (Weather Proof) or Equal
A/C Unit	Frigidaire	208/230V, 12000 BTU Wall Mount (Dedicated Circuit)

Note: Products may be substituted for an equal or better model.

**100 Amp. ELECTRICAL PANEL SCHEDULE
120/208-V, 4-Wire, Three Phase
10 Space, 20 Circuit Minimum**


Circuit Number & Type	Wire Size & Quantity	Breaker		Description
		Trip	Pole	
1	12-2	20	1	Recept
2	14-2	15	1	Lights
3/5	12-2	20	2	A/C
4/6	12-2	20	2	Wall Heater
7/9	12-2	20	2	Wall Heater

10 12-2 20 1 Water Heater


**DISTRIBUTION PANEL SIZING
120/240-V, 4-Wire, Three Phase**

Receptacles (4x180)	720 W
Lighting (96 sq. ft x 3.5w)	336 W
Wall Heater	7500 W
A/C	1170 W
Exterior Lighting	48.75 W
10543.5 W / 360 V = 29.2A Service Rating	

ELECTRICAL LEGEND

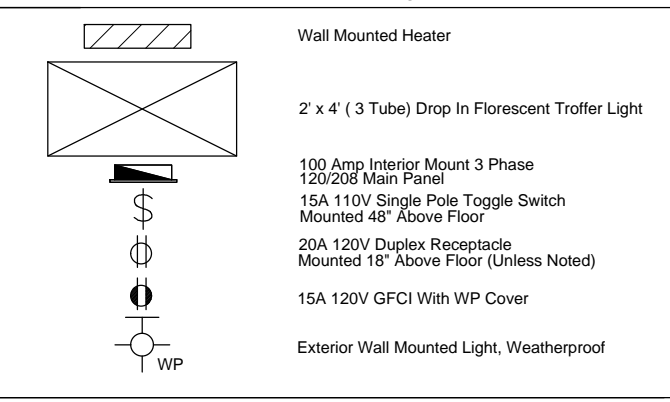

100 AMP ELECTRICAL RISER DIAGRAM

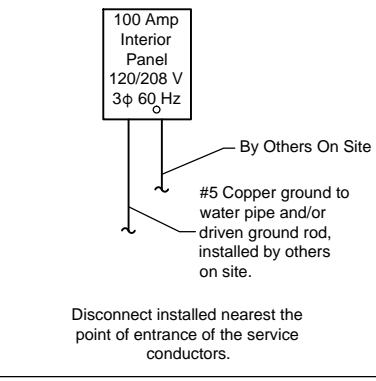

ELECTRICAL


- All Receptacles to be the grounding type.
- All Wiring to be per the edition of the NEC Listed on the Cover Page, Type MC CU with ground.
- Main panel to be marked "Suitable For Use As Service Equipment" and be equipped with breaker/ fuse type overcurrent protection.
- Proper thermal overload protection to be provided for all motors.
- Disconnecting means within sight required for all motors.
- Weather proof protection required for all outdoor lights, receptacles and disconnects.
- Proper working clearances shall be provided and maintained for all electrical equipment.
- All florescent fixture's required thermal protection and proper clearances from insulation, also applicable for incandescent fixture's.
- Combination exhaust fan/light and all recessed incandescent fixture's to be with thermal protection.
- Exit lights, if electric, must be fed from an approved emergency service connected ahead of, but not within main service disconnection means enclosure, and installed as per service requirements, or be battery backup type units.
- Service conductors located within the perimeter of the building, shall be installed in accordance with article 230-6, per the edition of the NEC on the cover page.
- Maximum 15 (2) tube florescent lights in 15A circuit, Maximum 10 recepts on 15A circuit, Maximum 7 (4) Tube florescent lights on a 15A circuit.
- Maximum 20 (2) tube florescent lights in 20A circuit, Maximum 13 recepts on 20A circuit, Maximum 10 (4) Tube florescent lights on a 120A circuit.
- All circuits and equipment shall be grounded in accordance with the appropriate articles of the National Electrical Code (NEC).
- HVAC equipment shall be provided with readily accessible disconnects adjacent to the equipment served. A unit switch with a marked "off" position that is a part of the HVAC equipment and disconnects all ungrounded conductors shall be permitted as the disconnecting means where other disconnecting means are also provided by a readily accessible circuit breaker.
- Prior to energizing the electrical system the interrupt rating of the main breaker must be designed by a local electrical consultant to verify compliance with NEC 110-9.
- The electrical feeders are designed by others, site installed and subject to review and approval by the authority having jurisdiction.
- Ceiling Luminary boxes shall be designed for the purpose and required to support a minimum of 50 lbs.

REVISIONS:	SCALE: 1/2" = 1'-0"	APPROVED BY:
	DATE: 06/07/2017	DRAWN BY: EAB

Twin Modular Services Inc.
Blackwood, NJ

TITLE: ELECTRICAL PLAN A	JOB NO: TMS060617-18
MODEL: 816 GUARDHOUSE	DRAWING NO: 4A

0107 2008-09-23

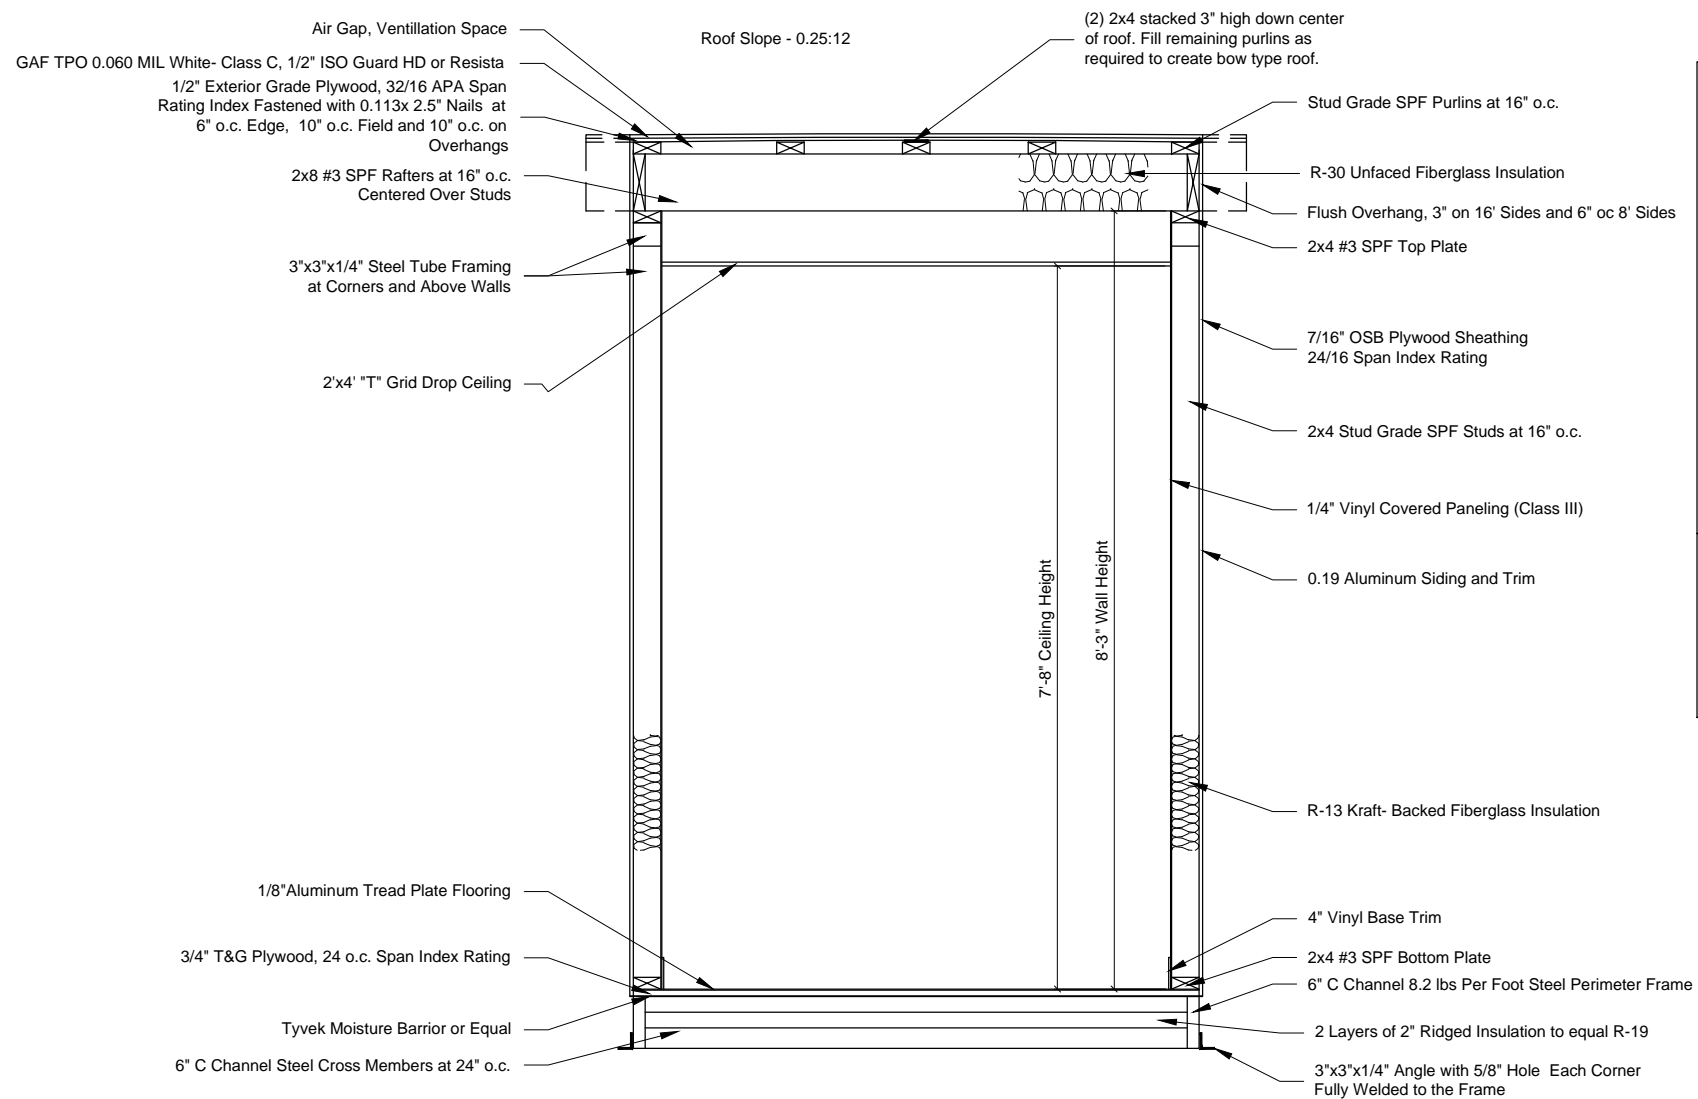

NTA, Inc., 305 N Oakland Ave
Nappanee, Indiana 46550

These drawings are applicable only to the elements and loading criteria specifically provided herein. These drawings shall not be construed in any way to specify, certify or design any aspects of the building not contained herein. Specified design criteria are based solely on information provided by the client and must be verified and approved by the local authority having jurisdiction. NTA, Inc. is not responsible for fabrication or erection. If it is suspected that these drawings have been modified, substituted or altered in any way, contact NTA, Inc. at (574) 773-7975 to obtain a file copy.

BUYER ACCEPTANCE SIGN AND DATE


- NOTES
- Fireblocking shall be installed at the floor and ceiling level. Fireblocking material shall be as permitted in North Carolina Building Code Exterior joints in the building envelope that are sources of air leakage, such as floor and ceiling lines, door and windows, or any other penetrations through the building envelope shall be caulked, gasketed, weather-stripped, wrapped or otherwise sealed to limit uncontrolled air movement. Stopping materials installed on-site are subject to local review, approval and inspection.
 - In all framed walls, floors and roof/ceiling comprising elements of the building thermal envelope, a vapor retarder shall be installed on the warm-in-winter side of the insulation with the following exceptions:
 - Where the framed cavity or space is ventilated to allow moisture to escape.
 - Where required, the vapor retarder shall be comprised of any material (kraft backing, polyethylene, spray applied) approved for such use and having a perm rating of 1 or less.
 - Additional connections per standard construction manual or calculations package

REVISIONS:	SCALE: 1/2" = 1'-0"	APPROVED BY:
	DATE: 06/07/2017	DRAWN BY: EAB

Twin Modular Services Inc.
Blackwood, NJ

TITLE: CROSS SECTION	JOB NO: TMS060617-18
MODEL: 816 GUARDHOUSE	DRAWING NO: 5

0110.1150 2008-12-02

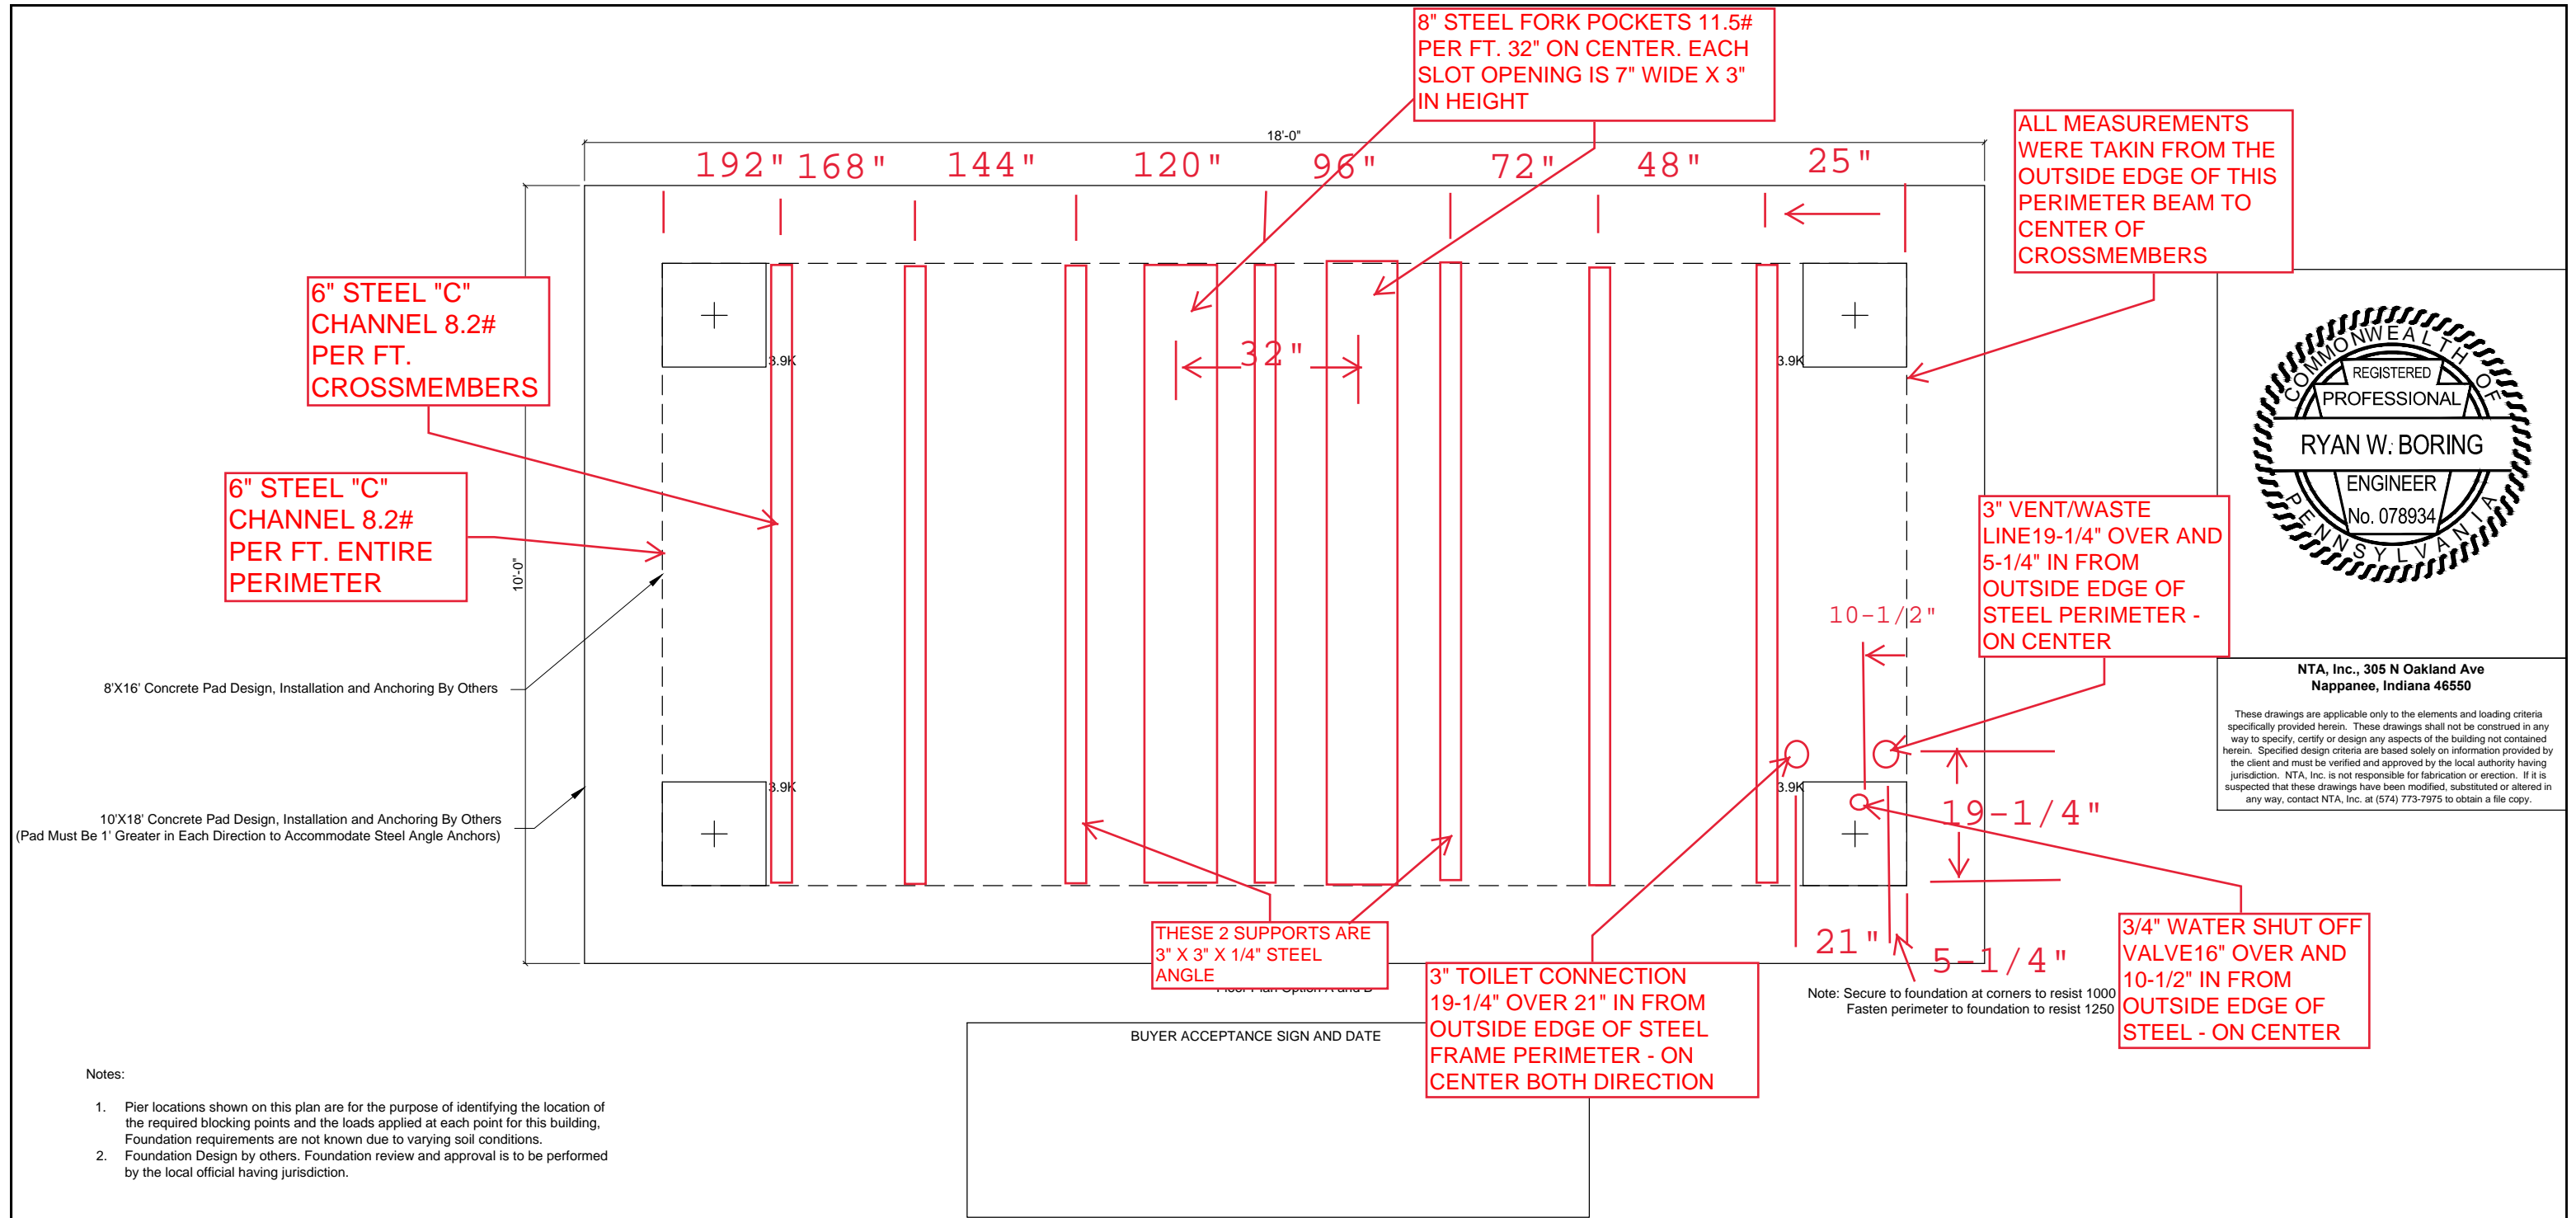

NTA, Inc., 305 N Oakland Ave
Nappanee, Indiana 46550

These drawings are applicable only to the elements and loading criteria specifically provided herein. These drawings shall not be construed in any way to specify, certify or design any aspects of the building not contained herein. Specified design criteria are based solely on information provided by the client and must be verified and approved by the local authority having jurisdiction. NTA, Inc. is not responsible for fabrication or erection. If it is suspected that these drawings have been modified, substituted or altered in any way, contact NTA, Inc. at (574) 773-7975 to obtain a file copy.

- Notes:
1. Pier locations shown on this plan are for the purpose of identifying the location of the required blocking points and the loads applied at each point for this building. Foundation requirements are not known due to varying soil conditions.
 2. Foundation Design by others. Foundation review and approval is to be performed by the local official having jurisdiction.

BUYER ACCEPTANCE SIGN AND DATE

THIS DRAWING IS NOT FOR CONSTRUCTION. This drawing is intended to show the minimum foundation loads and minimum foundation support locations and is not to be used for construction or certification of any foundation for any building. The foundation for this modular building shall be designed and sealed by a local engineer for the conditions present on-site in accordance with local codes. Additionally, the foundation designed by others shall be reviewed and approved by the local authority having jurisdiction.

FOUNDATION LEGEND	
+	Foundation to support load listed

0110.1150 2008-12-02

REVISIONS:	SCALE: 1/2" = 1'-0"	APPROVED BY:
	DATE: 06/07/2017	DRAWN BY: EAB

Twin Modular Services Inc.
Blackwood, NJ

TITLE: BLOCKING PLAN	JOB NO: TMS060617-18
MODEL: 816 GUARDHOUSE	DRAWING NO: 6